



Dart Aerospace Ltd.
1270 Aberdeen St
Hawkesbury, ON
K6A 1K7
Canada

Tel (613) 632-5200
Fax 613 632-5246

D3290-3

Job Sheet 181228



Part No: D3290-3

Job Qty: 6 ea

Part Name: Window



Part Weight: 0 lbs

Status: Scheduled

Priority: Medium

Job Created: 7/24/18

Job Tracking No:

Due Date: 8/31/18

Created By: Marie Lajeunesse

Type: Stock

Description:

Note: DWG REV C IPP A 04.08.18 New issue KJ/RF IPP B IPP C 07.05.29. Thermoform in-house DL IPP D 07.09.28 rev C dwg EC verified by: DD IPP E 07.11.28 Add --Hand finish deburring DL

Ship Via:

Bill of Materials

Job Routing

Op No	Operation	Qty	Start Date	Due Date	Standard		Workcenter/Supplier		Sign-off
					Setup hrs	Run Hrs	Workcenter / Supplier	Lead Time	
100	Purchasing	6 pcs		8/31/18	0.00	0.00	Purchasing		AUG 29 2018 DAS 61
105	Packaging	6 pcs		8/31/18	0.00	0.00	Packaging2		
110	QC	6 pcs		8/31/18	0.00	0.00	QC6		8107 7988 IS MJS 18-09-24
190	Packaging	6 pcs		8/31/18	0.00	0.00	Packaging3-1		
200	QC21-SA	6 Ea		8/31/18	0.00	0.00	QC21		

Part Op 100 - ISSUE P/O: 040594 SUPPLIER: PLASTECH MANUFACTURE D3290-3 AS PER DWG C OF C
Descriptions: IS REQUIRED

110 - ***Windows need to be protected at all time***

July 24, 2018 x 6 R h

Job BOM

Part / Item	Component Name	Quantity	Operation	Container
D3290-3P	Window	6 Ea (1 ea)	100-Purchasing	5106464 5106465
MACRLICS.125	1/8" Polycast li Sheet	18.9600 sf (3.16 ea)	100-Purchasing	

Job Allocations

Operation	Component Part	Required	Inventory	Allocated
100-Purchasing	D3290-3P	6	0	0
	MACRLICS.125	19	2,286	0

Part Specifications

Spec No	Description	Target/Tolerance	Limits	Type	Special Comments
1	Window	26.580Inches ± 0.030	26.610 26.550		
2	Window	16.080Inches ± 0.030	16.110 16.050		
3	Window	13.790Inches ± 0.030	13.820 13.760		
4	Window	12.400Inches ± 0.030	12.430 12.370		
5	Window	8.810Inches ± 0.030	8.840 8.780		

DQA: _____ Date: _____

WORK ORDER NON-CONFORMANCE / UPDATE





QA Closed: _____ Date: _____

Work Order update only ☐

Work Order: _____ Part No. _____ NCR No. _____	DISPOSITION Rework ☐ Scrap ☐ Use-as-is ☐ Suspected Unapproved ☐	AGAINST DEPARTMENT/PROCESS Skid-tube ☐ Machining ☐ Thermoforming ☐ Large Fab ☐ Cross tube ☐ Small Fab ☐ Finishing ☐ Composite ☐ Water Jet ☐ Prod. Eng. Coord. ☐ Rec/Store/Packaging ☐ Supplier ☐ Engineering ☐ Quality ☐ Other ☐			
Date :	Step #:	QTY Effective :		MRB (QSI042) Approval	
Description Work Order Deviation		Disposition		Completed By	
				Lead hand / Supervisor Approval Verification	
				QC / QA Coordinator Approval	
Root Cause		FAULT CATEGORY			
Environment ☐ Design ☐ Doc/Data ☐ Equip/Tooling ☐ Handling/Pre ☐ Material ☐ Internal Transport ☐ Tribal Knowledge ☐ LOA ☐ Substation ☐ Past Expiry Date ☐ Misidentified ☐	No Re-verification ☐ Operator ☐ Offset/Setup ☐ Supplier ☐ Training ☐ Use for Testing ☐ Poor Information ☐ Rushing ☐ Product Improvement ☐ Process Improvement ☐ Manufacturing Process ☐ Past Due ☐	Pressure/Forced ☐ Bending ☐ Centre Not Concentric ☐ Cracks ☐ Crimp/Kink/Ripple/Wave ☐ Cuffs ☐ Crushing ☐ Heat Treat ☐ Wave/Twist in Tube ☐ Marks/Chatter ☐	Temperature/Cure ☐ Set-up ☐ BOM/Route ☐ Broken/Damage/Defec ☐ Inspection Incomplete ☐ Contamination ☐ Countersink ☐ Cut Too Short ☐ Instructions Incomplete ☐ Drill Holes ☐	☐ Power Loss/Surge Date: 08/29/18	☐ Positioned Wrong Instructions: Various STC's

Job No: 181228
 Part: D3290-3
 Serial No/Batch: S106466
 Container No: S106466

 DART Aerospace Ltd.
 1270 Aberdeen Street
 Hawkesbury, ON K6A 1K7
 CANADA
 TEL: 1 813 632-5200
 Email: sales@dartaero.com
 www.dartaerospace.com

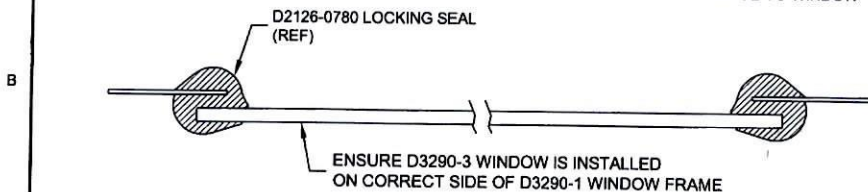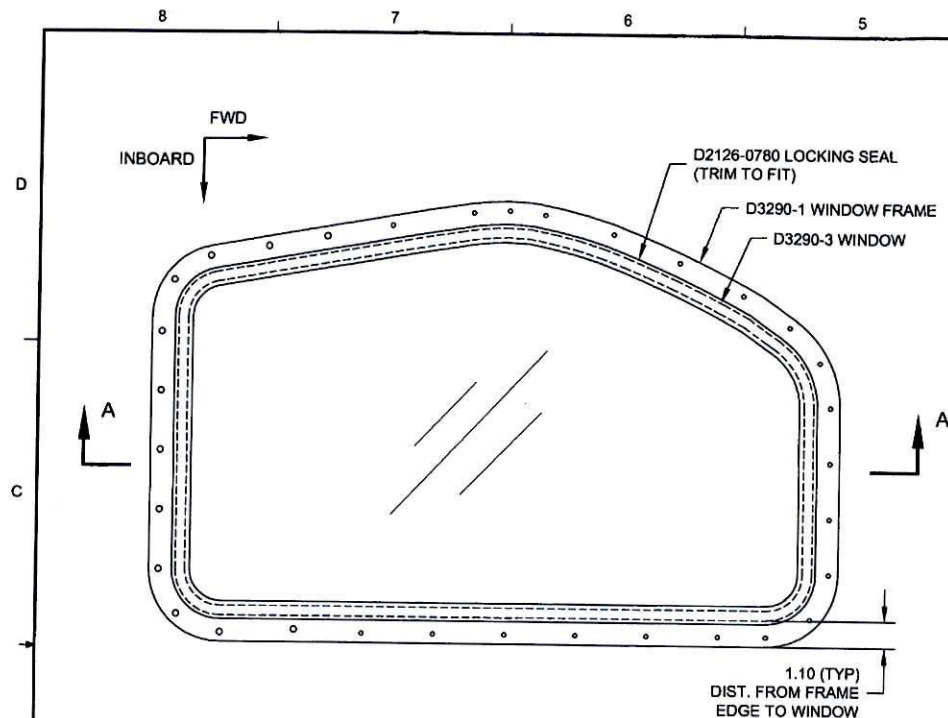


SECTION A-A
NTS

D3290-041 REPLACEMENT WINDOW ASSEMBLY

D3290-041 NOTES:
1) WEIGHT: 3.66 LBS

GENERAL NOTES:

- 1) TOLERANCES: PER DART QSI 018 UNLESS OTHERWISE NOTED
- 2) UNITS: INCHES UNLESS OTHERWISE NOTED

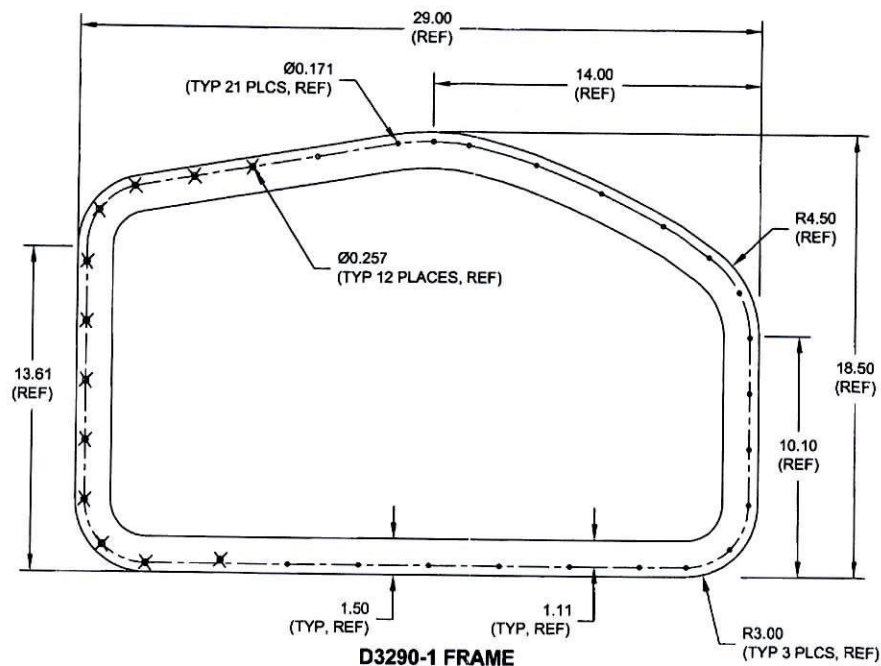

D3290-1 FRAME

D3290-1 NOTES:

- 1) MATERIAL: 6061-T6 (OR 6061-T62) ALUMINUM SHEET 0.040 THICK
PER AMS-QQ-A-250/11 OR AMS 4025 OR AMS 4027
(REF. DART SPEC. M6061T6S.040)
OR
5052-H32 ALUMINUM SHEET 0.040 THICK
PER AMS-QQ-A-250/8 OR AMS 4016
(REF. DART SPEC. M5052H32S.040)
- 2) FINISH: CHEMICAL CONVERSION COAT PER QSI 005 4.1
POWDER COAT WHITE (REF. 4.5.3.1) PER DART QSI 005 4.3
- 3) BREAK SHARP EDGES: 0.005 TO 0.010 MAX
- 4) IDENTIFICATION: IDENTIFY WITH DART P/N "D3290-1" USING FINE POINT PERMANENT INK MARKER
- 5) WEIGHT: 0.47 LBS

RELEASED
07.07.24
DEO ATTACHED

UNDER REVIEW

4409-01-18
7/15/07-07
6/17/19

C	UPDATE DIMS PER PAR 188	DC	07.07.24
B	UPDATE MATERIAL PER NCR 029	MB	06.04.20
A	NEW ISSUE	RF	04.06.14
REV.	DESCRIPTION	BY	DATE
DESIGN			
DRAWN			
CHECKED			
MFG. APPR.			
APPROVED			
DE APPR.			
DATE	07.07.24		

DART AEROSPACE LTD HAWKESBURY, ONTARIO, CANADA	
DRAWING NO. D3290	REV. C
TITLE REPLACEMENT WINDOW ASSEMBLY	SHEET 1 OF 2
SCALE 1:5	

COPYRIGHT © 2004 BY DART AEROSPACE LTD
THIS DOCUMENT IS UNCLASSIFIED AND IS SUPPLIED ON THE EXPRESS CONDITION THAT IT IS NOT TO BE USED FOR ANY PURPOSE OR COMMUNICATED TO ANY OTHER PERSON WITHOUT WRITTEN PERMISSION FROM DART AEROSPACE LTD

DQA: _____ Date: _____




WORK ORDER NON-CONFORMANCE / UPDATE

QA Closed: _____ Date: _____

Work Order update only ☐

Work Order: _____ Part No. _____ NCR No. _____	DISPOSITION Rework ☐ Scrap ☐ Use-as-is ☐ Suspected Unapproved ☐	AGAINST DEPARTMENT/PROCESS Skid-tube ☐ Machining ☐ Thermoforming ☐ Large Fab ☐ Cross tube ☐ Small Fab ☐ Finishing ☐ Composite ☐ Water Jet ☐ Prod. Eng. Coord. ☐ Rec/Store/Packaging ☐ Supplier ☐ Engineering ☐ Quality ☐ Other ☐			
Date :	Step #:	QTY Effective :		MRB (QSI042) Approval	
Description Work Order Deviation			Disposition		
			Completed By		
			Lead hand / Supervisor Approval Verification		
			QC / QA Coordinator Approval		
Root Cause		FAULT CATEGORY			
Environment ☐ Design ☐ Doc/Data ☐ Equip/Tooling ☐ Handling/Pre ☐ Material ☐ Internal Transport ☐ Tribal Knowledge ☐ LOA ☐ Substation ☐ Past Expiry Date ☐ Misidentified ☐	No Re-verification ☐ Operator ☐ Offset/Setup ☐ Supplier ☐ Training ☐ Use for Testing ☐ Poor Information ☐ Rushing ☐ Product Improvement ☐ Process Improvement ☐ Manufacturing Process ☐ Past Due ☐	Pressure/Forced ☐ Bending ☐ Centre Not Concentric ☐ Cracks ☐ Crimp/Kink/Ripple/Wave ☐ Cuffs ☐ Crushing ☐ Heat Treat ☐ Wave/Twist in Tube ☐ Marks/Chatter ☐	Temperature/Cure ☐ Set-up ☐ BOM/Route ☐ Broken/Damage/Defect ☐ Inspection Incomplete/Unqualified ☐ Contamination ☐ Countersink ☐ Cut Too Short ☐ Instructions Incomplete/Unclear ☐ Drill Holes ☐	Power Loss/Surge ☐ Folio/Program ☐ Grain ☐ Weld ☐ Wrong Stock Pulled ☐ Out of Sequence ☐ Off-set ☐ Misabeled ☐ Fit/Function ☐ Misaligned/off center ☐	Positioned Wrong ☐ Outside Dimensions ☐ Over/Under tolerance ☐ Part Incorrect ☐ Part Lost/Missing ☐ Part Moved ☐ Drawing ☐ Finish ☐ Misread ☐ Turning Sequence ☐
OTHER : ☐					

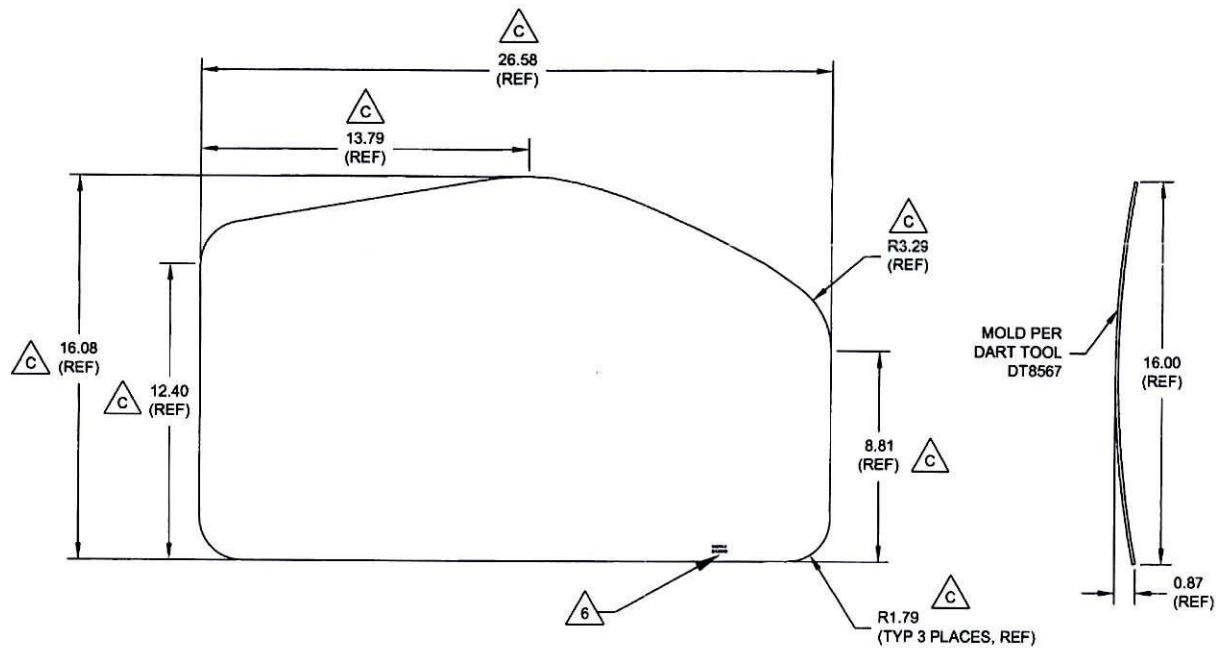

D3290-3 WINDOW

D3290-3 NOTES:

- 1) MATERIAL: POLYCAST II CLEAR ACRYLIC SHEET PER MIL-P-5425
OR PLEXIGLAS G CLEAR CAST ACRYLIC SHEET PER
LP-391 TYPE 1 GRADE C, 0.125 THICK
(REF. DART SPEC. M-ACRYLIC-S.125)
- 2) FINISH: NONE
- 3) TOLERANCES: PER DART QSI 018 UNLESS OTHERWISE NOTED
- 4) UNITS: INCHES UNLESS OTHERWISE NOTED
- 5) REMOVE SHARP EDGES
- 6) IDENTIFICATION: ENGRAVE P/N "D3290-3" AND B/N ON LOWER EDGE
USE 0.125" HIGH LETTERS TO MAXIMUM DEPTH OF 0.005"
- 7) WEIGHT: 1.87 +/- 0.42 LBS
- 8) MOLD PER DART TOOL DT8567

UNDER REVIEW
07.07.24

DEO ATTACHED
RELEASED
07.07.24

DESIGN		DART AEROSPACE LTD	
DRAWN		HAWKESBURY, ONTARIO, CANADA	
CHECKED		DRAWING NO.	REV. C
MFG. APPR.		D3290	SHEET 2 OF 2
APPROVED		TITLE	SCALE
DE APPR.		REPLACEMENT WINDOW ASSEMBLY	1:5
DATE	07.07.24	COPYRIGHT © 2004 BY DART AEROSPACE LTD	
THIS DOCUMENT IS PRIVATE AND CONFIDENTIAL AND IS SUPPLIED ON THE EXPRESS CONDITION THAT IT IS NOT TO BE USED FOR ANY PURPOSE OR COPIED OR COMMUNICATED TO ANY OTHER PERSON WITHOUT WRITTEN PERMISSION FROM DART AEROSPACE LTD.			

DQA: _____ Date: _____



WORK ORDER NON-CONFORMANCE / UPDATE

QA Closed: _____ Date: _____

Work Order update only ☐

Work Order: _____ Part No. _____ NCR No. _____	DISPOSITION Rework ☐ Scrap ☐ Use-as-is ☐ Suspected Unapproved ☐	AGAINST DEPARTMENT/PROCESS Skid-tube ☐ Machining ☐ Thermoforming ☐ Large Fab ☐ Cross tube ☐ Small Fab ☐ Finishing ☐ Composite ☐ Water Jet ☐ Prod. Eng. Coord. ☐ Rec/Store/Packaging ☐ Supplier ☐ Engineering ☐ Quality ☐ Other ☐			
Date :	Step #:	QTY Effective :		MRB (QSI042) Approval	
Description Work Order Deviation			Disposition		
			Completed By		
			Lead hand / Supervisor Approval Verification		
			QC / QA Coordinator Approval		
Root Cause		FAULT CATEGORY			
Environment ☐ Design ☐ Doc/Data ☐ Equip/Tooling ☐ Handling/Pre ☐ Material ☐ Internal Transport ☐ Tribal Knowledge ☐ LOA ☐ Substation ☐ Past Expiry Date ☐ Misidentified ☐	No Re-verification ☐ Operator ☐ Offset/Setup ☐ Supplier ☐ Training ☐ Use for Testing ☐ Poor Information ☐ Rushing ☐ Product Improvement ☐ Process Improvement ☐ Manufacturing Process ☐ Past Due ☐	Pressure/Forced ☐ Bending ☐ Centre Not Concentric ☐ Cracks ☐ Crimp/Kink/Ripple/Wave ☐ Cuffs ☐ Crushing ☐ Heat Treat ☐ Wave/Twist in Tube ☐ Marks/Chatter ☐	Temperature/Cure ☐ Set-up ☐ BOM/Route ☐ Broken/Damage/Defect ☐ Inspection Incomplete/Unqualified ☐ Contamination ☐ Countersink ☐ Cut Too Short ☐ Instructions Incomplete/Unclear ☐ Drill Holes ☐	Power Loss/Surge ☐ Folio/Program ☐ Grain ☐ Weld ☐ Wrong Stock Pulled ☐ Out of Sequence ☐ Off-set ☐ Mislabeled ☐ Fit/Function ☐ Misaligned/off center ☐	Positioned Wrong ☐ Outside Dimensions ☐ Over/Under tolerance ☐ Part Incorrect ☐ Part Lost/Missing ☐ Part Moved ☐ Drawing ☐ Finish ☐ Misread ☐ Turning Sequence ☐
OTHER : _____					

DRAWING NO. D3290	TITLE REPLACEMENT WINDOW ASSEMBLY	REV. C	DART AEROSPACE LTD ENGINEERING ORDER		D.E.O. NO. D3290-C-1	SHEET NO. SHEET 1 OF 1	SCALE NTS
DRAWN <i>q</i>	CHECKED <i>b</i>	MFG. APPR. <i>E</i>	APPROVED <i>MP</i>		DE APPR. <i>#</i>		
DATE 09.09.18	DATE 09.09.18	DATE 09.09.18	DATE 09/09/21		DATE 09/09/21		

PURPOSE:

CHANGE MATERIAL THICKNESS OF D3290-1 FRAME TO 0.063 FROM 0.040. REF PAR 09-033.

CHANGE:

MATERIAL CALL-OUT OF D3290-1 FRAME ON SHEET 1 IS AMENDED AS FOLLOWS:

D3290-1 NOTES

- 1) MATERIAL: 6061-T6 (OR 6061-T62) ALUMINUM SHEET ~~0.040 THICK~~ 0.063 THICK (REPLACE)
 PER AMS-QQ-A-250/11 OR AMS 4025 OR AMS 4027
~~(REF. DART SPEC. M6061T6S.040)~~ REF. DART SPEC. M6061T6S.063 (REPLACE)
 OR
 5052-H32 ALUMINUM SHEET ~~0.040 THICK~~ 0.063 THICK (REPLACE)
 PER AMS-QQ-A-250/8 OR AMS 4016
~~(REF. DART SPEC. M5052H32S.040)~~ REF. DART SPEC. M5052H32S.063 (REPLACE)

RELEASED
 2009 -10- 09
MP

DQA: _____ Date: _____



WORK ORDER NON-CONFORMANCE / UPDATE

QA Closed: _____ Date: _____

Work Order update only ☐

Work Order: _____ Part No. _____ NCR No. _____		DISPOSITION Rework ☐ Scrap ☐ Use-as-is ☐ Suspected Unapproved ☐		AGAINST DEPARTMENT/PROCESS Skid-tube ☐ Machining ☐ Thermoforming ☐ Large Fab ☐ Cross tube ☐ Small Fab ☐ Finishing ☐ Composite ☐ Water Jet ☐ Prod. Eng. Coord. ☐ Rec/Store/Packaging ☐ Supplier ☐ Engineering ☐ Quality ☐ Other ☐					
Date :		Step #:		QTY Effective :			MRB (QSI042) Approval Completed By Lead hand / Supervisor Approval Verification QC / QA Coordinator Approval		
Description Work Order Deviation				Disposition					
Root Cause		FAULT CATEGORY							
Environment ☐	No Re-verification ☐	Pressure/Forced ☐	Temperature/Cure ☐	Power Loss/Surge ☐	Positioned Wrong ☐				
Design ☐	Operator ☐	Bending ☐	Set-up ☐	Folio/Program ☐	Outside Dimensions ☐				
Doc/Data ☐	Offset/Setup ☐	Centre Not Concentric ☐	BOM/Route ☐	Grain ☐	Over/Under tolerance ☐				
Equip/Tooling ☐	Supplier ☐	Cracks ☐	Broken/Damage/Defect ☐	Weld ☐	Part Incorrect ☐				
Handling/Pre ☐	Training ☐	Crimp/Kink/Ripple/Wave ☐	Inspection Incomplete/Unqualified ☐	Wrong Stock Pulled ☐	Part Lost/Missing ☐				
Material ☐	Use for Testing ☐	Cuffs ☐	Contamination ☐	Out of Sequence ☐	Part Moved ☐				
Internal Transport ☐	Poor Information ☐	Crushing ☐	Countersink ☐	Off-set ☐	Drawing ☐				
Tribal Knowledge ☐	Rushing ☐	Heat Treat ☐	Cut Too Short ☐	Mislabeled ☐	Finish ☐				
LOA ☐	Product Improvement ☐	Wave/Twist in Tube ☐	Instructions Incomplete/Unclear ☐	Fit/Function ☐	Misread ☐				
Substation ☐	Process Improvement ☐	Marks/Chatter ☐	Drill Holes ☐	Misaligned/off center ☐	Turning Sequence ☐				
Past Expiry Date ☐	Manufacturing Process ☐								
Misidentified ☐	Past Due ☐								
		OTHER : _____							



Dart Aerospace Ltd.
1270 Aberdeen St
Hawkesbury, ON
K6A 1K7
Canada

Tel (613) 632-5200

PURCHASE ORDER **PO040594**

Supplier: PLA002-VC
Plas-Tech
115 Applewood Crescent
Concord
ON
L4K 5C1 Canada
Phone: 416-736-0004
Fax: 416-736-0010

PO No: PO040594
PO Date: 7/24/18
Due Date: 8/31/18
Purchase Order
Revision:
Revision Date:
Ship-To Contact: Lussier, Patrick
Phone:

Ship To: 1270 Aberdeen Street
Hawkesbury
ON
K6A 1K7 Canada
Phone: 613-632-5200

Via: Ground
Pynt Terms: Net 60
Freight Terms:
Special Comments:

Items

Line Item	Job	Part	Supplier Part No	Item No	Description	Status	Account	Due Date	Order Quantity	Received Quantity	Balance	Unit Price (CAD)	Extended Price
1	181228	D3290-3P	DAS 61 9-89		Window : Various STC's As Per Dwg D3290 Rev. C	Firmed	-	8/31/18	6 Ea	0 Ea	6 Ea	\$45.00/Ea	\$270.00
Line Item Note W/O 181228 Grand Total: \$270.00													

Order Notes

Terms & Condition of Purchasing(Suppliers) and Procurement Quality Clauses are an integral part of our AS9100 requirements. To learn in detail, please visit www.dartaerospace.com for further explanation.

Procurement Quality Clauses

- A005 RIGHT OF ENTRY
- A007 FIRST ARTICLE INSPECTION (FAI) BY SELLER, (DOCUMENTATION MAINTAINED BY SUPPLIER)
- A012 CHEMICAL AND PHYSICAL TEST REPORTS
- A016 PERSONNEL QUALIFICATION
- A017 RAW MATERIAL IDENTIFICATION (AS APPLICABLE)
- A026 CERTIFICATION OF MATERIAL CONFORMANCE
- A041 QUALITY MANAGEMENT SYSTEM
- A042 DART NOTIFICATION BY SUPPLIER
- A043 RETENTION OF QUALITY DOCUMENT
- A048 COUNTERFEIT PARTS AVOIDANCE, DETECTION, MITIGATION AND DISPOSITION PROGRAM
- A049 SUPPLIER AWARENESS

Plex 7/24/18 3:25 PM dart.Lussier.Patrick



115 Applewood Crescent
Concord, ON, L4K 5C1
PLASTECHONLINE.COM
P- 416 736 0004
F- 416 736 0010

Packing Slip

Shipment Number: 30741
Shipment Date: 08/28/2018
BOL Number:
Customer Key: C1887
Salesperson: MIKE AUBE
Page Number: 1 of 1

B DART AEROSPACE LTD.
I 1270 ABERDEEN STREET
L HAWKESBURY ON K6A 1K7
L CA
T Attn: DALE BATES
O Buyer Contact: PATRICK LUSSIER

S DART AEROSPACE
H 1270 ABERDEEN STREET
I HAWKESBURY ON K6A 1K7
P CA
T Attn: PATRICK LUSSIER
O

Purchase Order

40594

Carrier Account #

151793240

Sales Order

SO-024575

Ship Via

FEDERAL EXPRESS - Ground

Incoterms

EX WORKS

Payment Method

COL

Tracking Number

773071430505

Item Number
Revision

D3290-3P - Rev.: C

Description

REPLACEMENT WINDOW ASSEMBLY

AS PER DWG D3290 REV C

Quantity
Shipped

6

UOM

EA

DAS
61
9-89

Number of Containers

Gross Weight

Shipped By

Certificate Of Conformance



Customer: DART AEROSPACE LTD P.O. # 40594 SO # 024575-

Part #	<u>D3290-3P</u>	Qty.	<u>6</u>	Batch #	<u>-001</u>	DAS 6 9-80
Description	<u>REPLACEMENT WINDOW</u>	Material usage	<u>1 SHEET</u>	Lot#	<u>240394</u>	
Part #		Qty.		Batch #		
Description		Material usage		Lot#		
Part #		Qty.		Batch #		
Description		Material usage		Lot#		
Note: All parts are not identified as meeting QSI044.

By: AB
(Approved QA Signatory)

Date: AUG 24, 2018 C O F C # 082

Page: 1 of 1

Plas-Tech Inc. 115 Applewood Cres. Concord, Ontario L4K 5C1 Tel: (416) 736-0004 Fax: (416) 736-0010

Email: info@plastechonline.com, Web: www.plastechonline.com